



FOR CONSTRUCTION

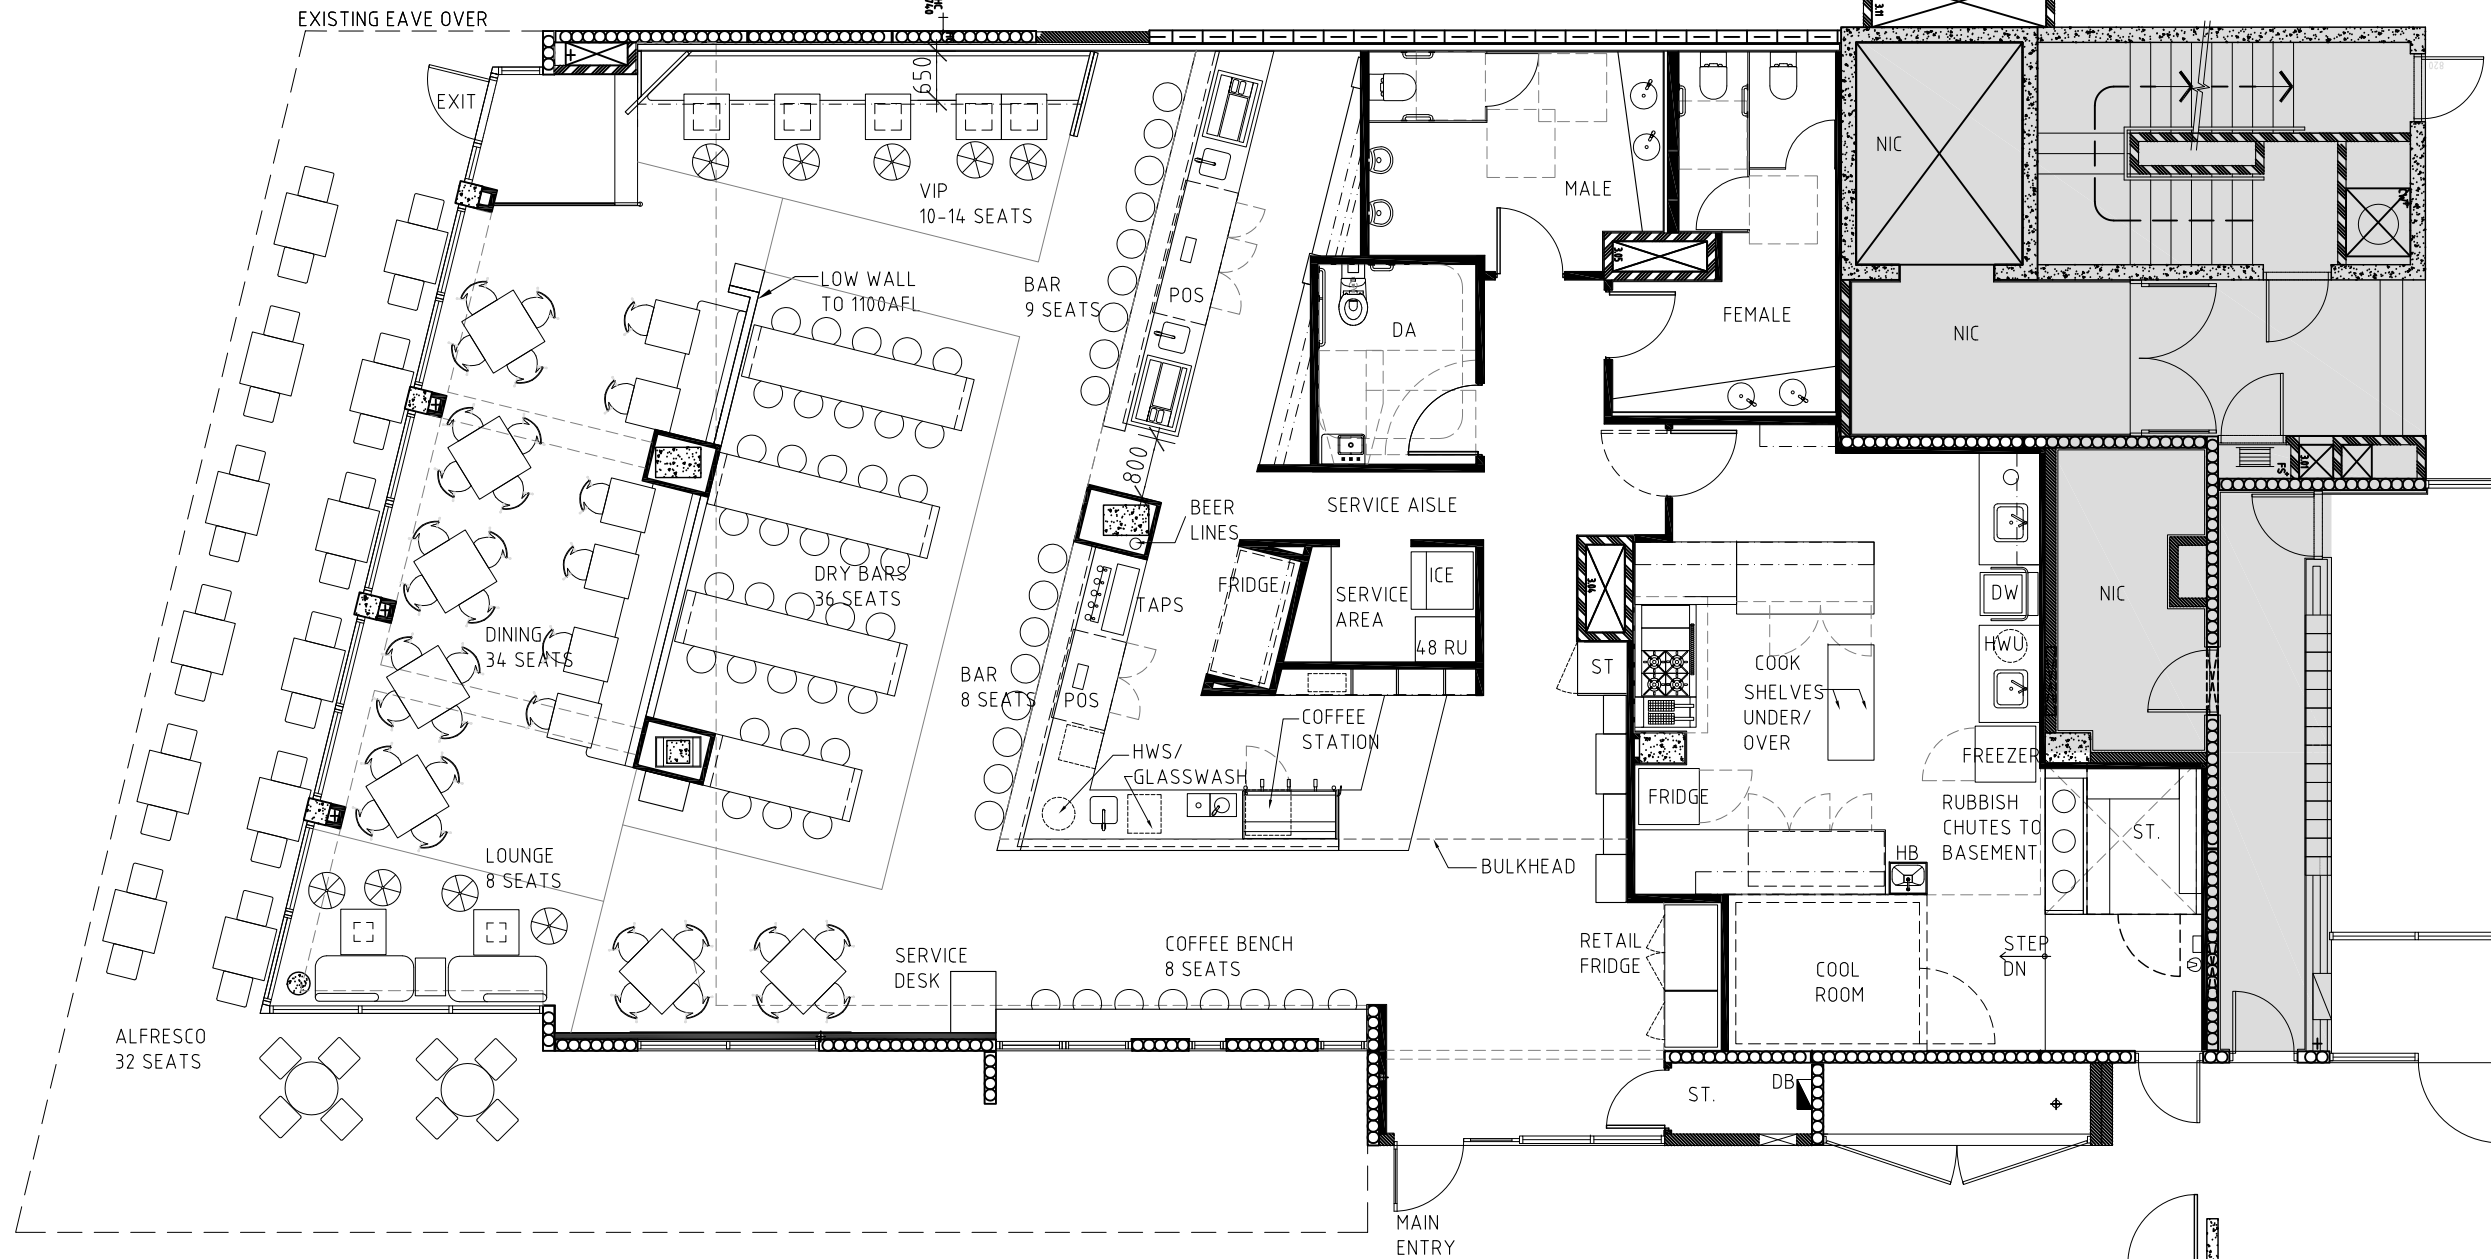


GROUND FLOOR PLAN

Scale 1:100

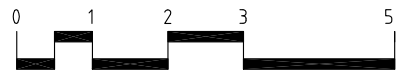

BASEMENT PLAN

Scale 1:100

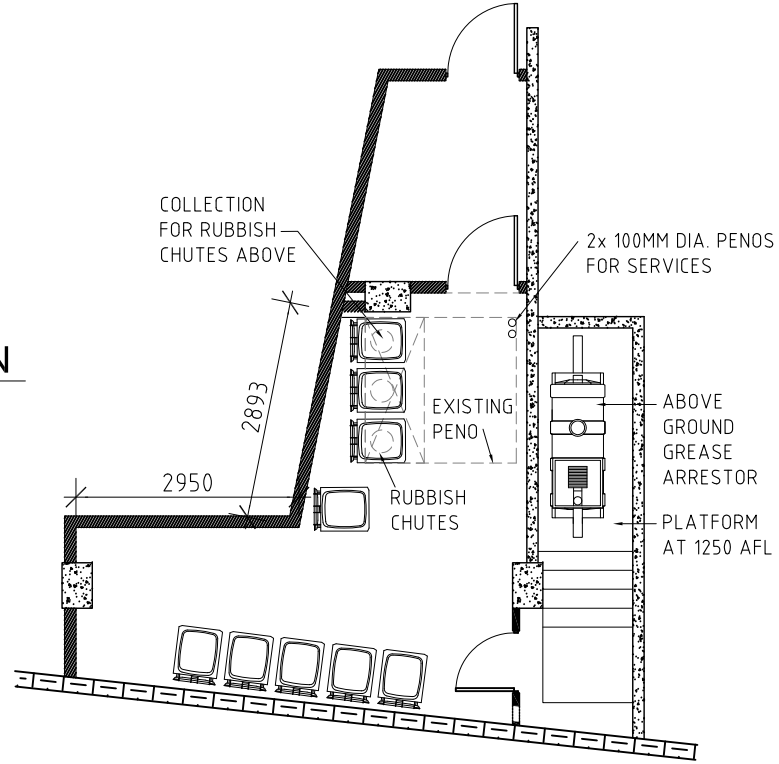

PARTITIONING LEGEND

NEW GYPROCK PARTITION, 2000R SOUND RATED
76MM STUD FULL HEIGHT WITH 13MM GYPROCK SHEETING - SELECTED PAINT FINISH, REFER TO FINISHES SCHEDULE.

NOTES

10	AS BUILT DRAWINGS	9.10.14
9	ALFRESCO	19.9.14
8	ALFRESCO	31.7.14
7	SEATING CHANGES	23.7.14
6	HALF WALL ADDED	26.6.14
REV: DETAILS:		DATE:

Contractors must check all dimensions on site and confirm quantities before starting any work or shop drawings. Do not scale off drawings. Copyright © 2013. Drawings may not be copied or reproduced without the written consent of the designer

CLIENT
LEIGHTON RESTAURANT
LOT 1, 1 FREEMAN LOOP
LEIGHTON BEACH, NORTH FREMANTLE

STIELY DESIGN
commercial, hospitality & residential interior design
0429.146.122

DRAWING TITLE
CONCEPT PLAN

DATE	DRAWN BY	DRAWING NO.
2.5.13	JS	01
SCALE	REVISION	
1:100@A3	10	

